

11-DEC-2012 14:40

TIME\$\$\$ 006043ut27
Chad. Havens 8825Full.pen

R:\07400004\006043\DGN\As Bullets\DGN\006043ut27.dgn

STATE GA PROJECT NUMBER CSNHS-0006-001043

SHEET NO. 341 TOTAL SHEETS 668

AS-BUILT PLANS 12/12/12

C:\USERS\CHAD.HAVENS\DESKTOP\CSNHS-0006-001043\DRAWINGS\12-12-12\12-12-12.dwg

MATCH LINE STA. 418+00

I-575 S.B.

686+00

687+00

688+00

689+00

690+00

691+00

CONST. Q
I-575

I-575 N.B.

419+00

420+00

421+00

422+00

423+00

CONST. Q
RAMP "B"

MATCH LINE STA. 424+00

EXIST. ROPE MILL ROAD

EXIST. R/W & L/A


EXIST. R/W & L/A

NOTE: NO UTILITIES WERE FOUND
INSIDE THE LIMIT OF SURVEY
ON THIS SHEET.

PROPERTY AND EXISTING R/W LINE — P —
 REQUIRED R/W LINE — G —
 CONSTRUCTION LIMITS — G — F —
 EASEMENT FOR CONSTR & MAINTENANCE OF SLOPES — H — H —
 EASEMENT FOR CONSTR OF SLOPES — X — X —
 EASEMENT FOR CONSTR OF DRIVES — X — X —

BEGIN LIMIT OF ACCESS.....BLA
 END LIMIT OF ACCESS.....ELA
 LIMIT OF ACCESS — O — O —
 REQ'D R/W & LIMIT OF ACCESS — H — H —

THE LPA
GROUP
TRANSPORTATION CONSULTANTS
A UNIT OF MICHAEL BAKER CORPORATION
3595 ENGINEERING DRIVE
NORCROSS, GEORGIA 30092
(770) 263-9118

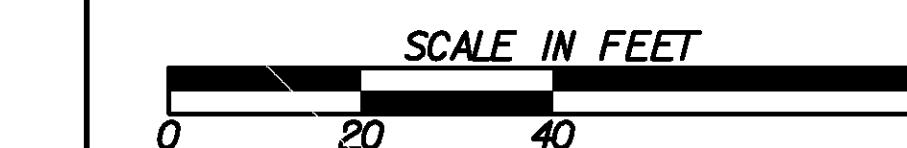

REVISION DATES

STATE OF GEORGIA
DEPARTMENT OF TRANSPORTATION

OFFICE: INNOVATIVE PROGRAM DELIVERY

UTILITY PLANS

I-575 NB ENTRANCE LANE
STA. 418+00 TO STA. 424+00DRAWING NO.
24-027